

ATTENTION ALL TRADE EXHIBITORS

THE ATTACHED MAP IS A MAP OF THE ENTIRE
SHOWGROUNDS

THE **RED LINE** INDICATES THE UNDERGROUND SERVICES


**** POWER** ** WATER ** ** DRAINS** ** PHONE ****

THESE LINES ARE ONLY AN INDICATION

PLEASE CHECK YOUR SITE AREA AND FAMILIARISE YOURSELF
WITH THE SERVICES LOCATIONS

IF YOU HAVE ANY CONCERNS THAT YOU MAY HIT SOMETHING
WITH YOUR MARQUEE PEG OR OTHER INGROUND ITEM


CONTACT DUGALD THOMAS 0274 415 621

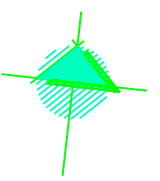

ALL INTERNAL SITE BOUNDARIES AND LOCATION OF SERVICES ARE INDICATIVE ONLY

LEGEND

- TREASURER'S HUT
- EFTPOS
- POLICE
- ST. JOHN (FIRST AID)
- LOST CHILD
- TOILET
- TOILET (WHEEL CHAIR)
- WATER POINT
- POWER POINT
- POLE
- POST
- FIRE HYDRANT
- TREE

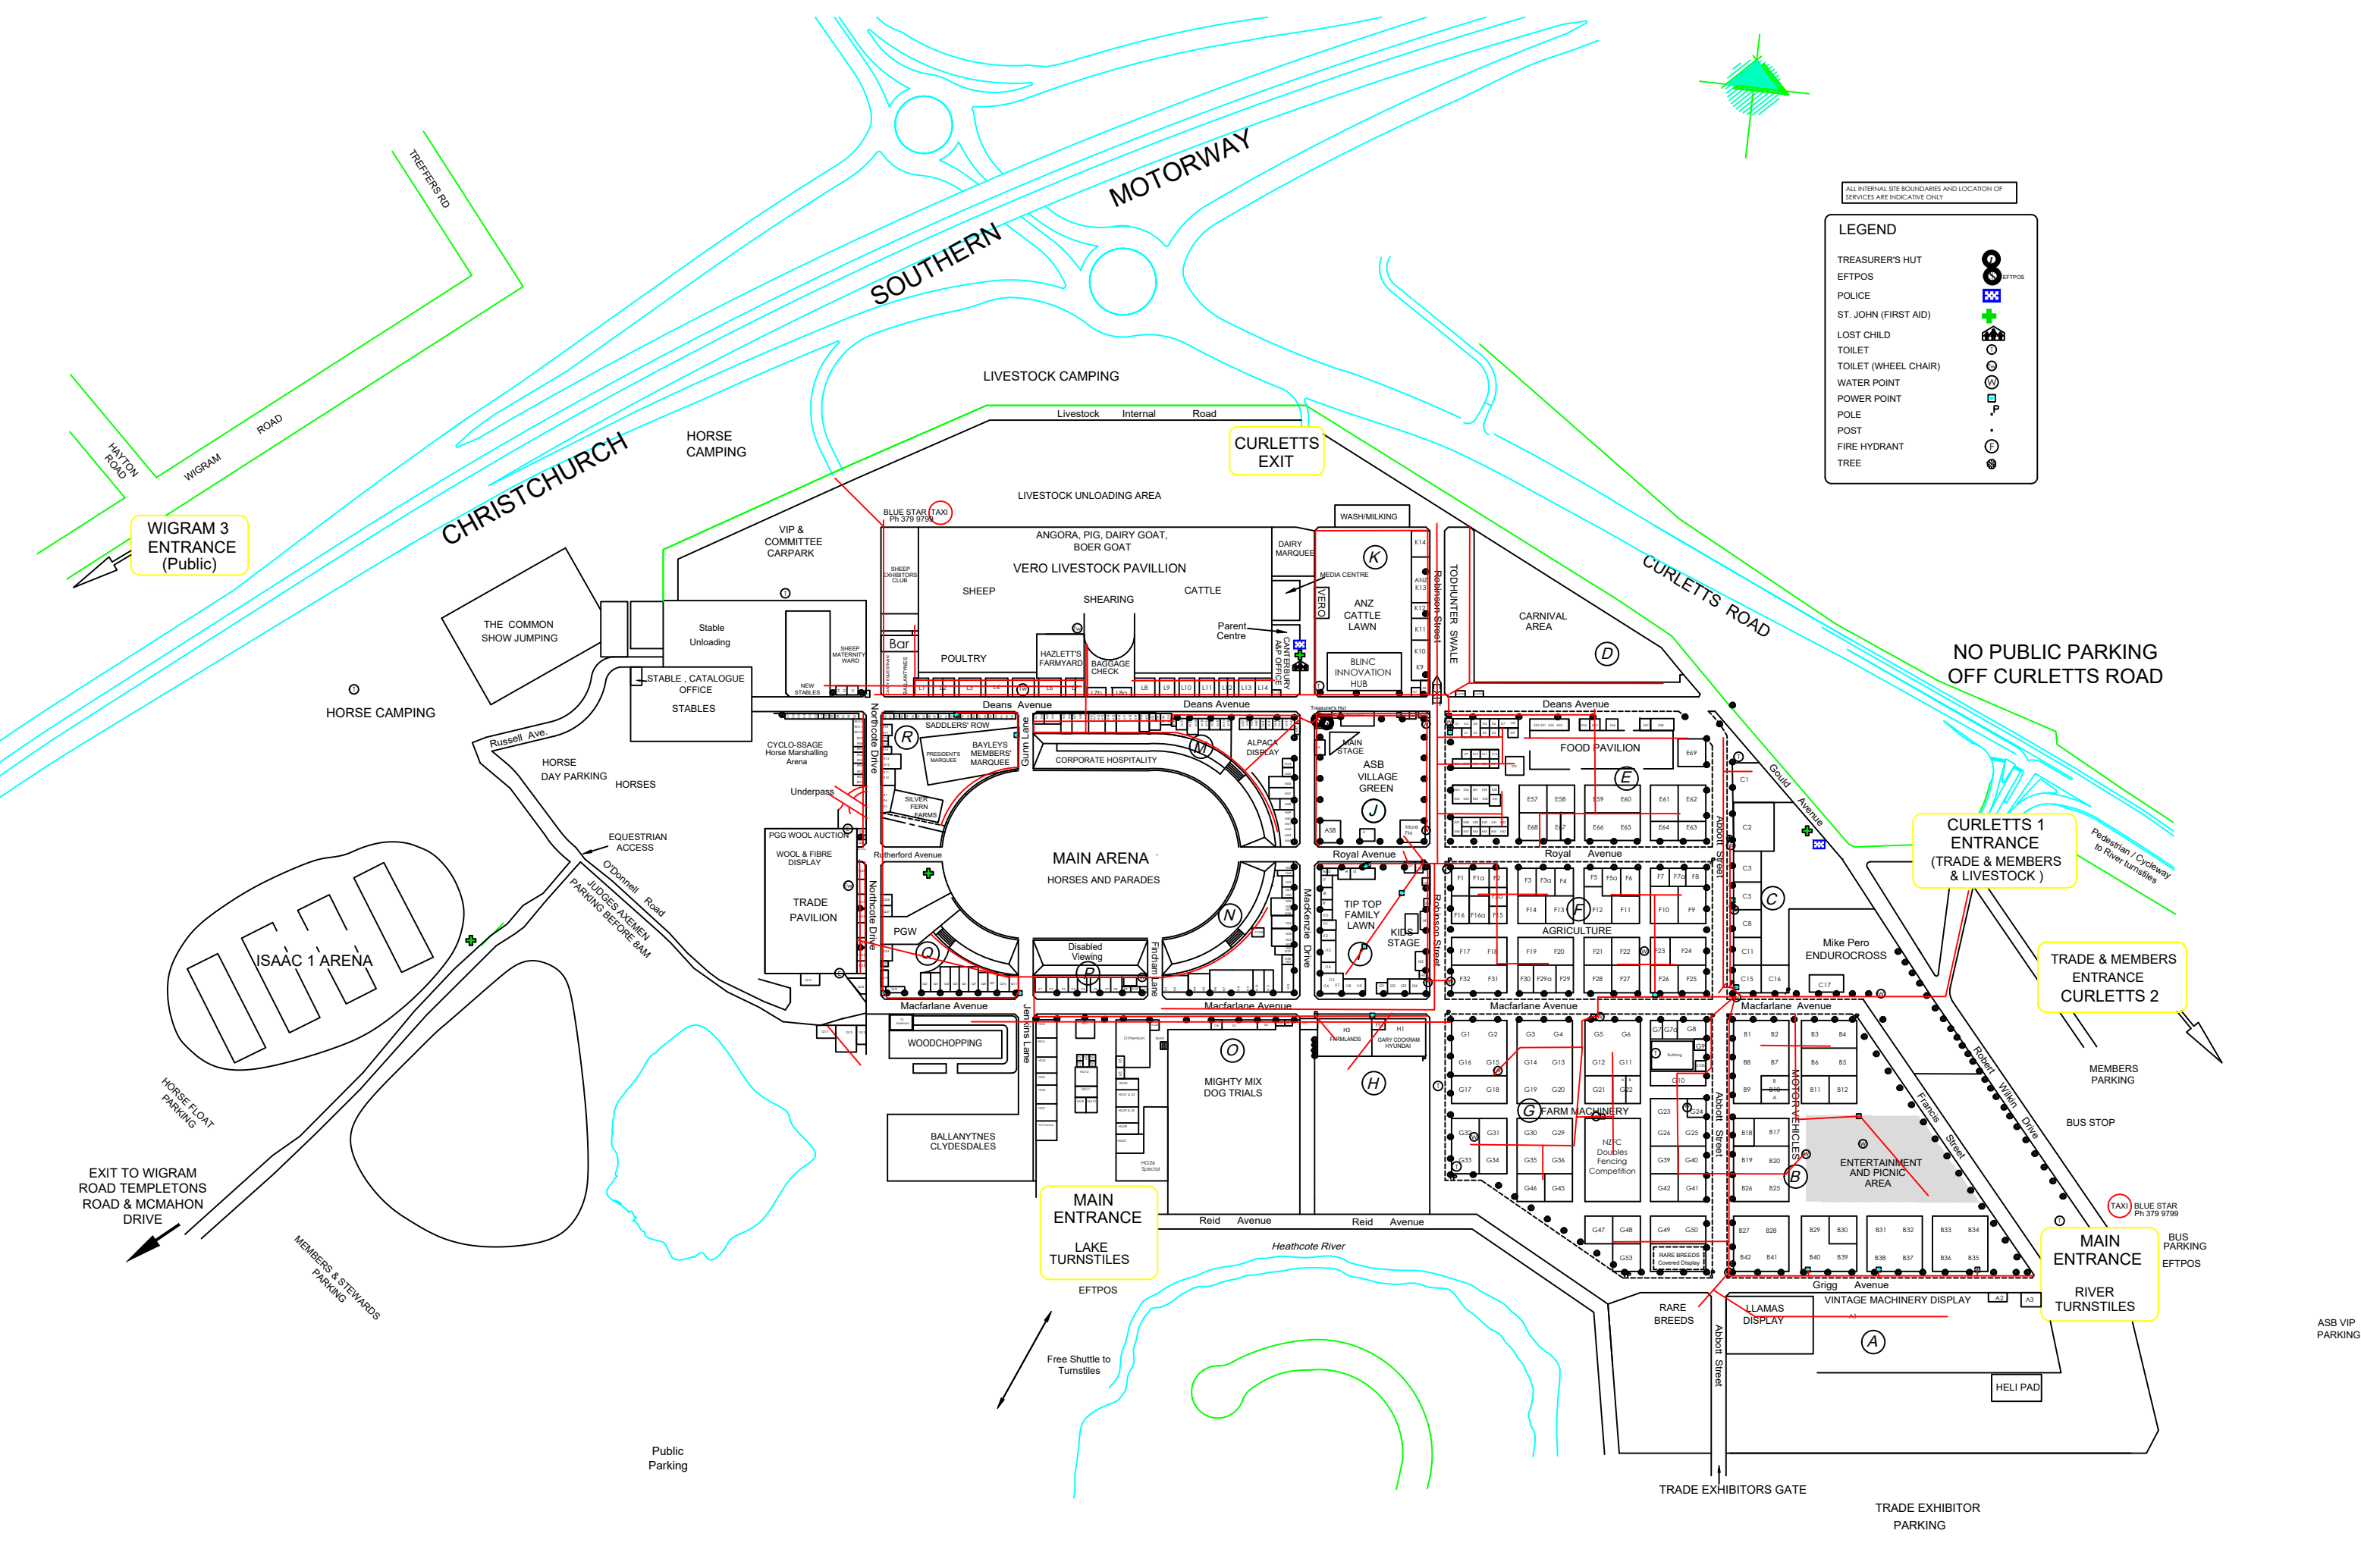

WIGRAM 3 ENTRANCE
(Public)

CURLETT'S EXIT

CURLETT'S 1 ENTRANCE
(TRADE & MEMBERS & LIVESTOCK)

TRADE & MEMBERS ENTRANCE
CURLETT'S 2

MAIN ENTRANCE
LAKE TURNSTILES

MAIN ENTRANCE
RIVER TURNSTILES

NO PUBLIC PARKING
OFF CURLETT'S ROAD

EXIT TO WIGRAM ROAD
TEMPLETONS ROAD & MCMAHON DRIVE

MEMBERS & STEWARDS PARKING

Public Parking

Free Shuttle to Turnstiles

TRADE EXHIBITORS GATE

TRADE EXHIBITOR PARKING

ASB VIP PARKING